


**KEY PLAN**

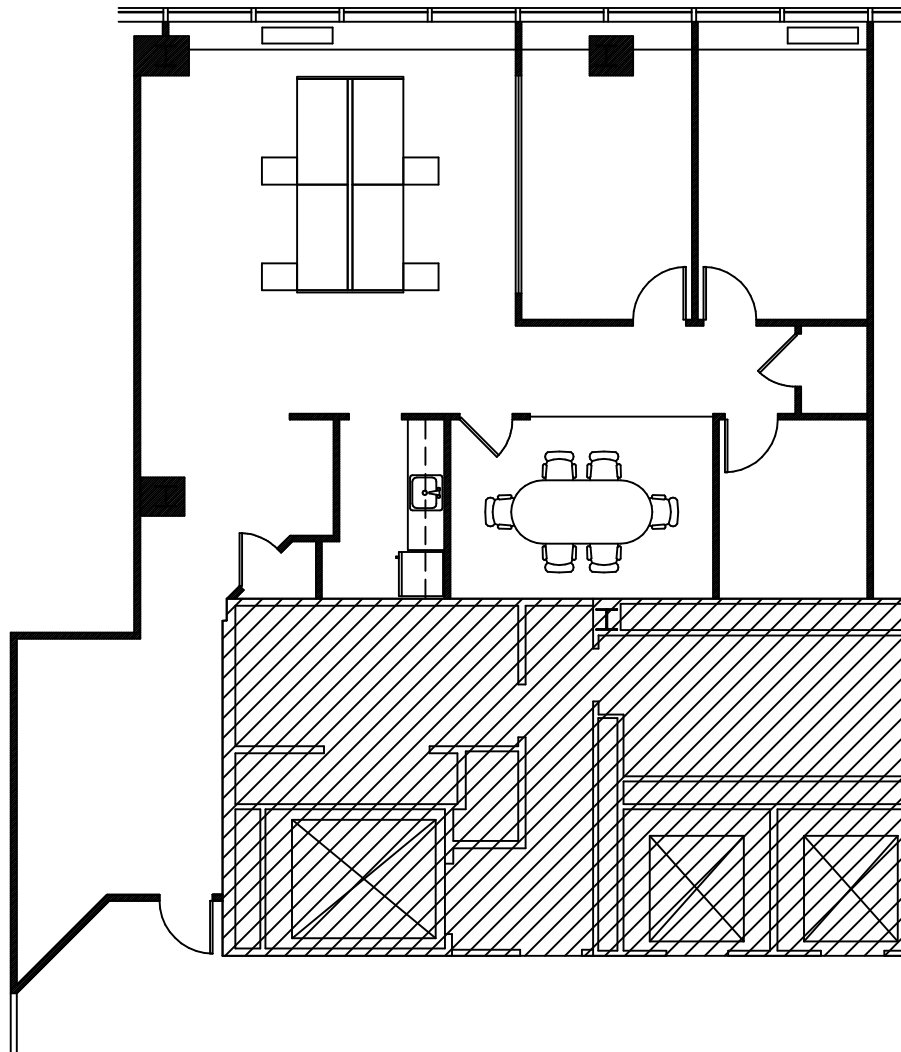

**RFR**  
RFR REALTY LLC

**2 STAMFORD PLAZA  
SUITE 1203  
STAMFORD, CONNECTICUT**

**AS-BUILT FLOOR PLAN  
2,117 SQ. FT.**

**25 JANUARY 2012**



**NORTH**

**PROJ. NO. 20112**



**ARCHITECTS**